
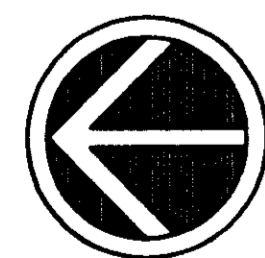


COMMON INTEREST COMMUNITY NUMBER 591


CONDOMINIUM

HERITAGE SQUARE SECOND ADDITION CONDOMINIUMS
FIRST SUPPLEMENTAL COMMON INTEREST COMMUNITY PLAT

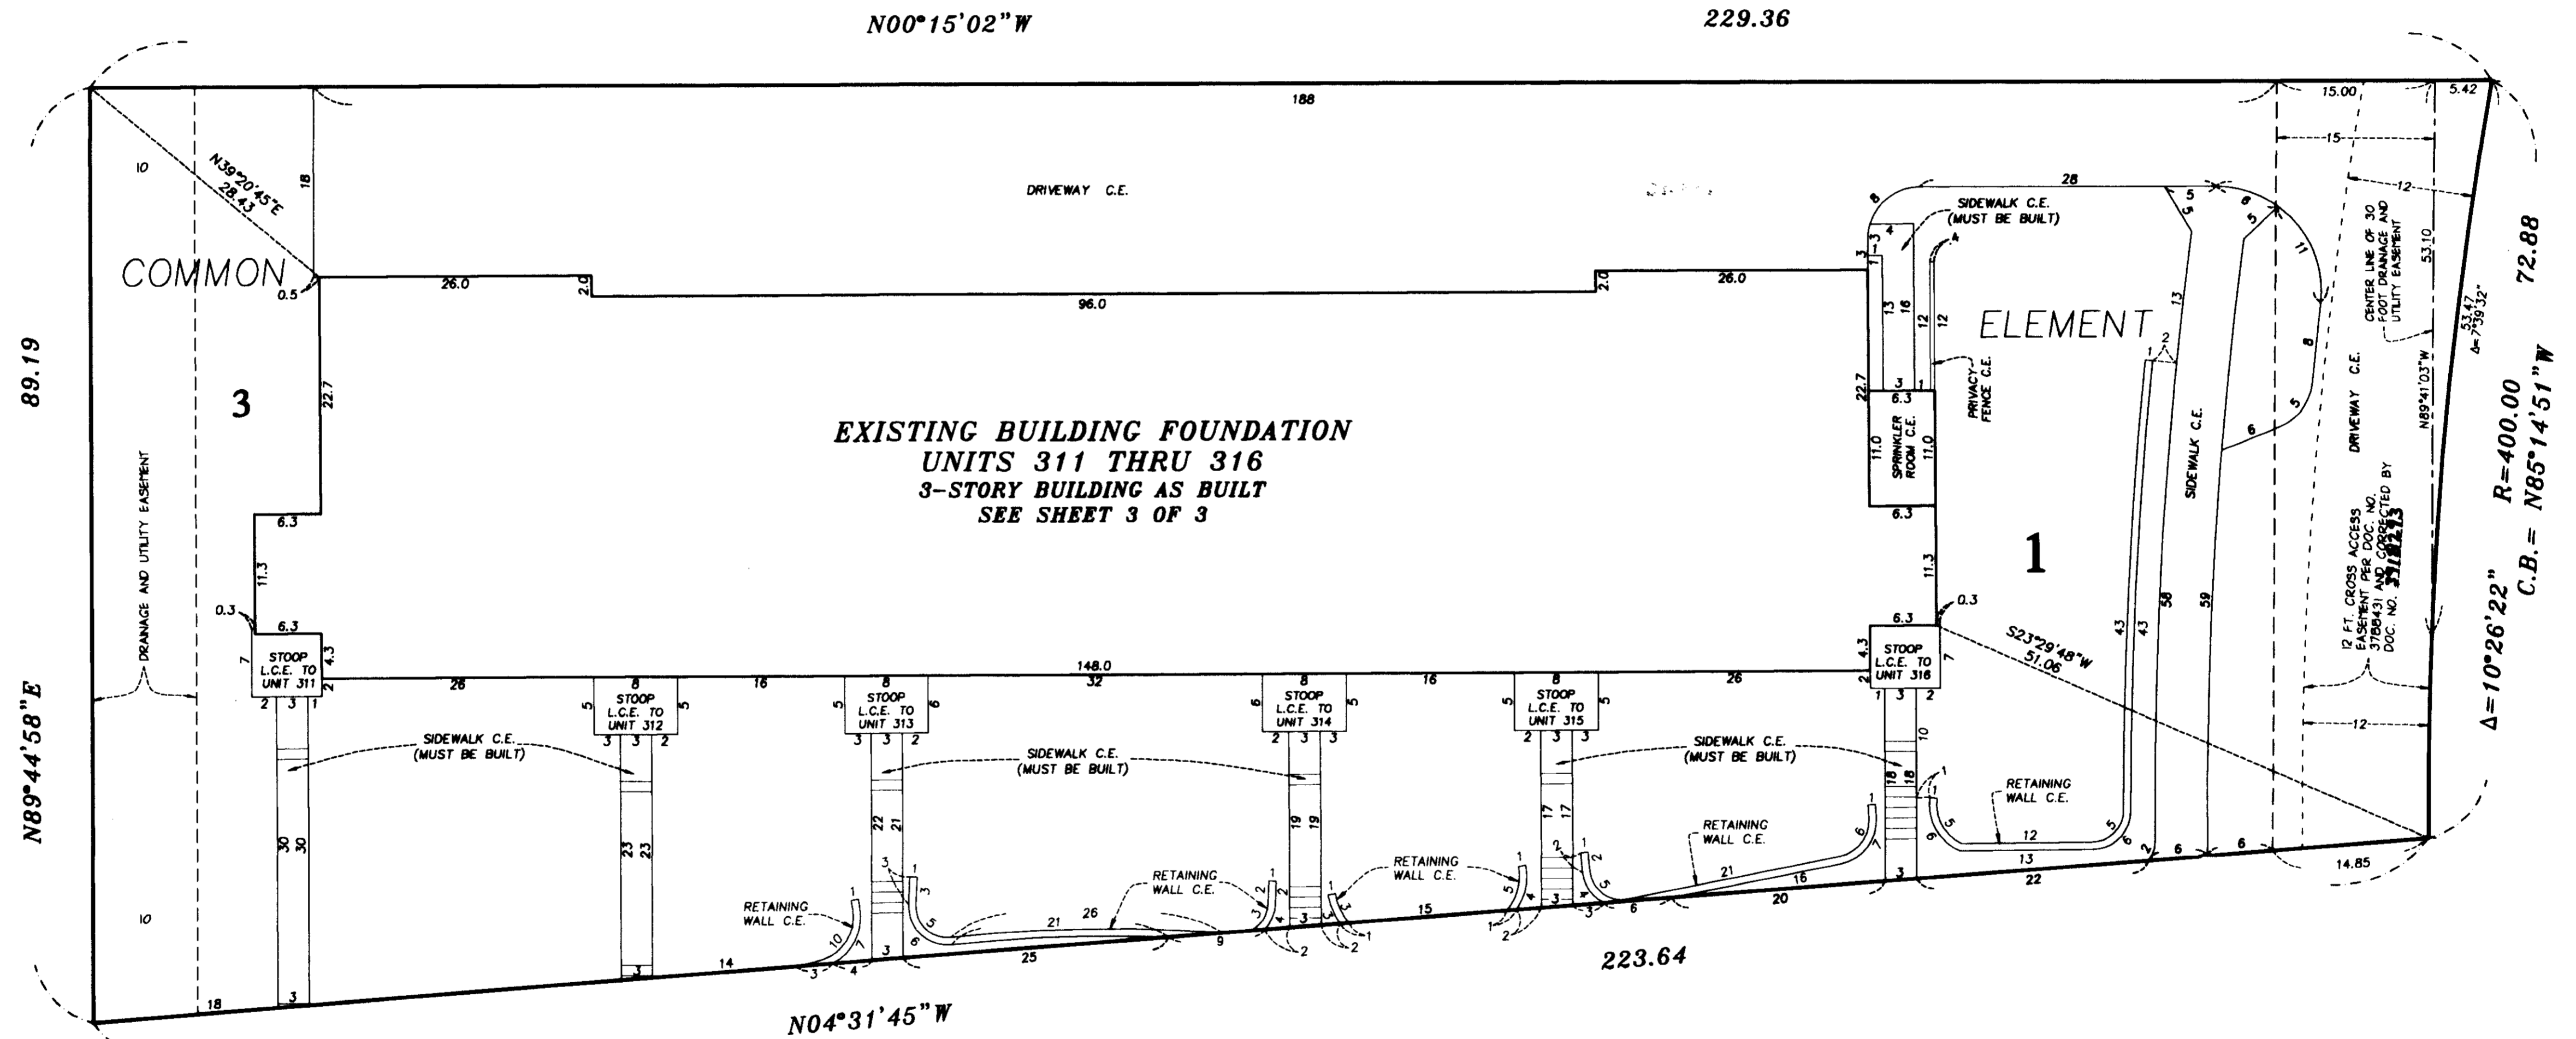

NORTH

SCALE: 1 INCH = 10 FEET

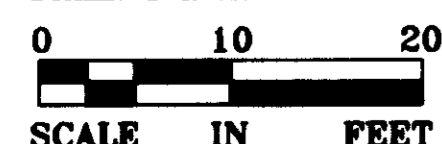

SCALE IN FEET

NOTE: ALL RETAINING WALLS MUST BE BUILT

C.E. - DENOTES COMMON ELEMENT

L.C.E. - DENOTES LIMITED COMMON ELEMENT

C.B. - DENOTES CHORD BEARING

BENCH MARK:

TOP NUT OF HYDRANT LOCATED 76 FEET EAST AND 1,014 FEET SOUTH OF THE SOUTHWEST CORNER OF THIS COMMON INTEREST COMMUNITY

ELEVATION = 923.86 FEET (NGVD 1929 DATUM)




UNIT DETAIL
AS BUILT

COMMON INTEREST COMMUNITY NUMBER 591


CONDOMINIUM

HERITAGE SQUARE SECOND ADDITION CONDOMINIUMS FIRST SUPPLEMENTAL COMMON INTEREST COMMUNITY PLAT



LOWEST LEVEL -

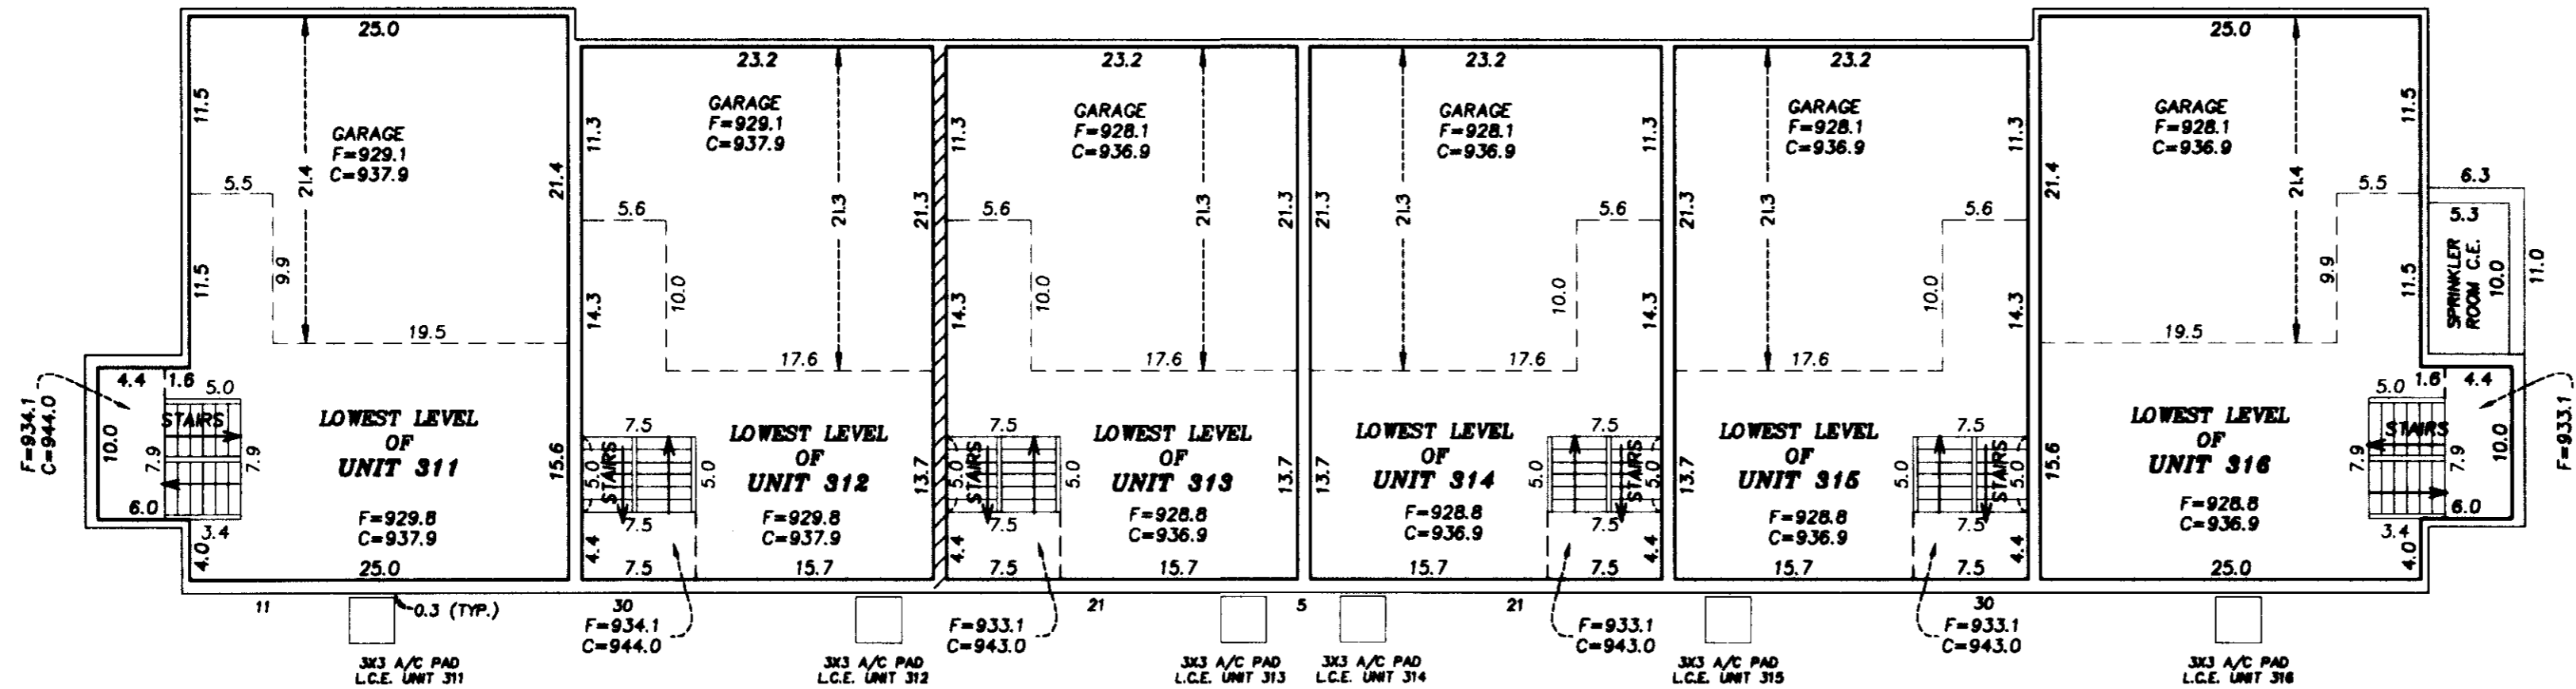

MID LEVEL -

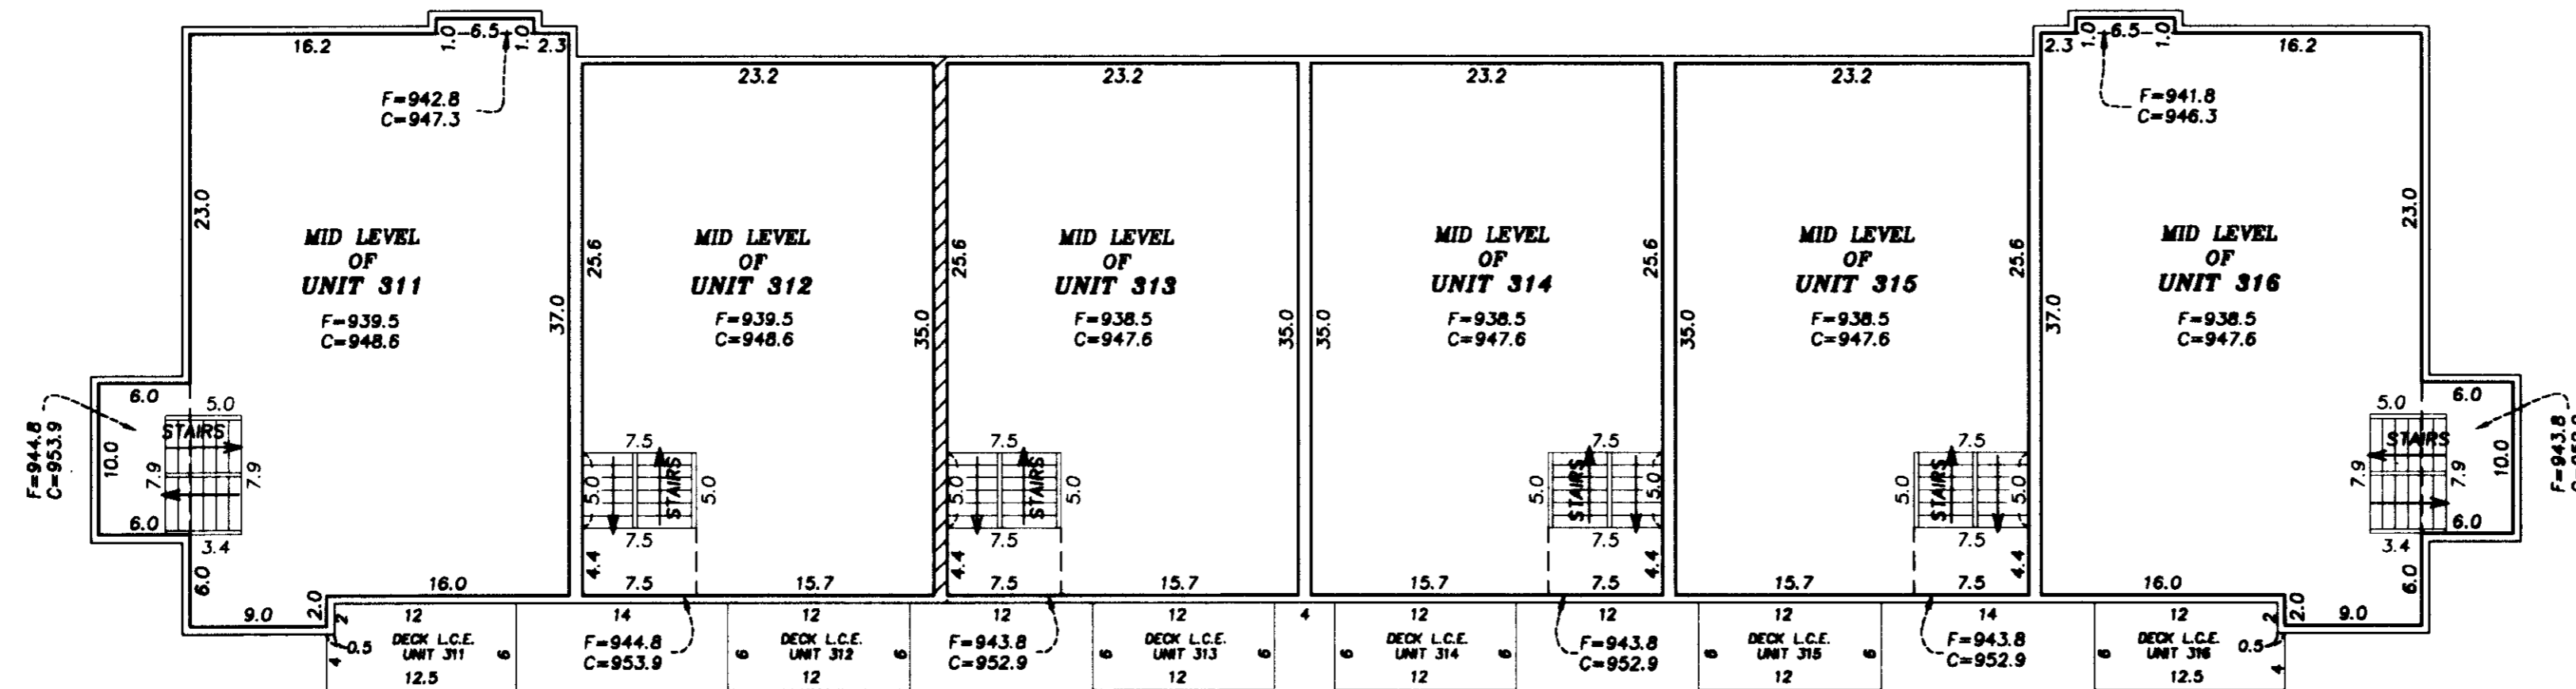

UPPER LEVEL -

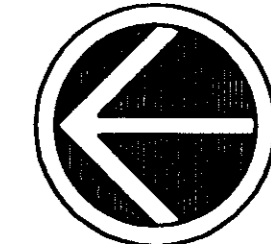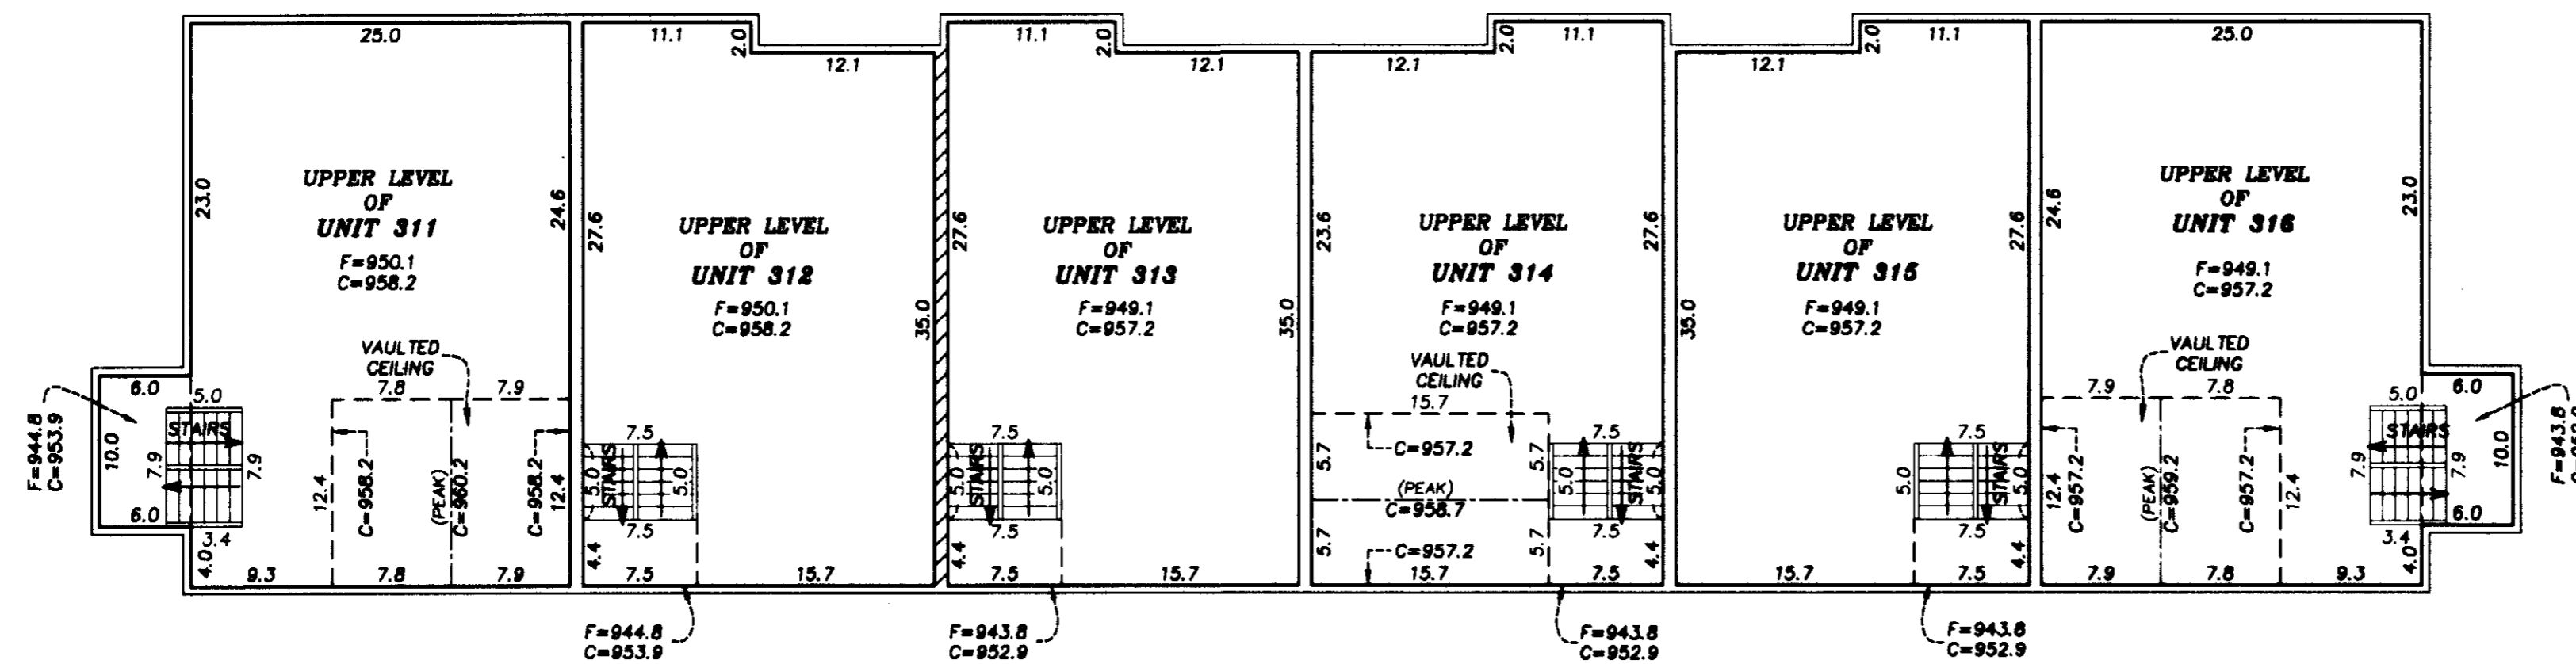

NORTH

SCALE: 1 INCH = 10 FEET



SCALE IN FEET

- C.E. - DENOTES COMMON ELEMENT
- L.C.E. - DENOTES LIMITED COMMON ELEMENT
- C - DENOTES CEILING ELEVATION
- F - DENOTES FLOOR ELEVATION
- //// - DENOTES GRADE BREAK

INTERIOR DIMENSIONS SHOWN ARE MEASURED TO THE UNFINISHED SURFACE OF THE WALLS, FLOORS AND CEILINGS.

ELEVATIONS ARE REFERENCED TO A BENCH MARK AS NOTED ON SHEET 2 OF 3 SHEETS AND ARE SHOWN IN FEET AND TENTHS OF A FOOT.

