





UNIT DETAIL  
AS BUILT



OFFICIAL

# COMMON INTEREST COMMUNITY NUMBER 591

CONDOMINIUM


## HERITAGE SQUARE SECOND ADDITION CONDOMINIUMS FOURTH SUPPLEMENTAL COMMON INTEREST COMMUNITY PLAT

LOWEST LEVEL -

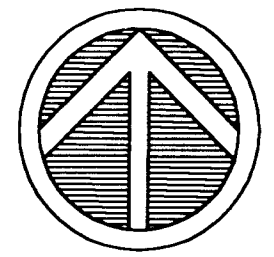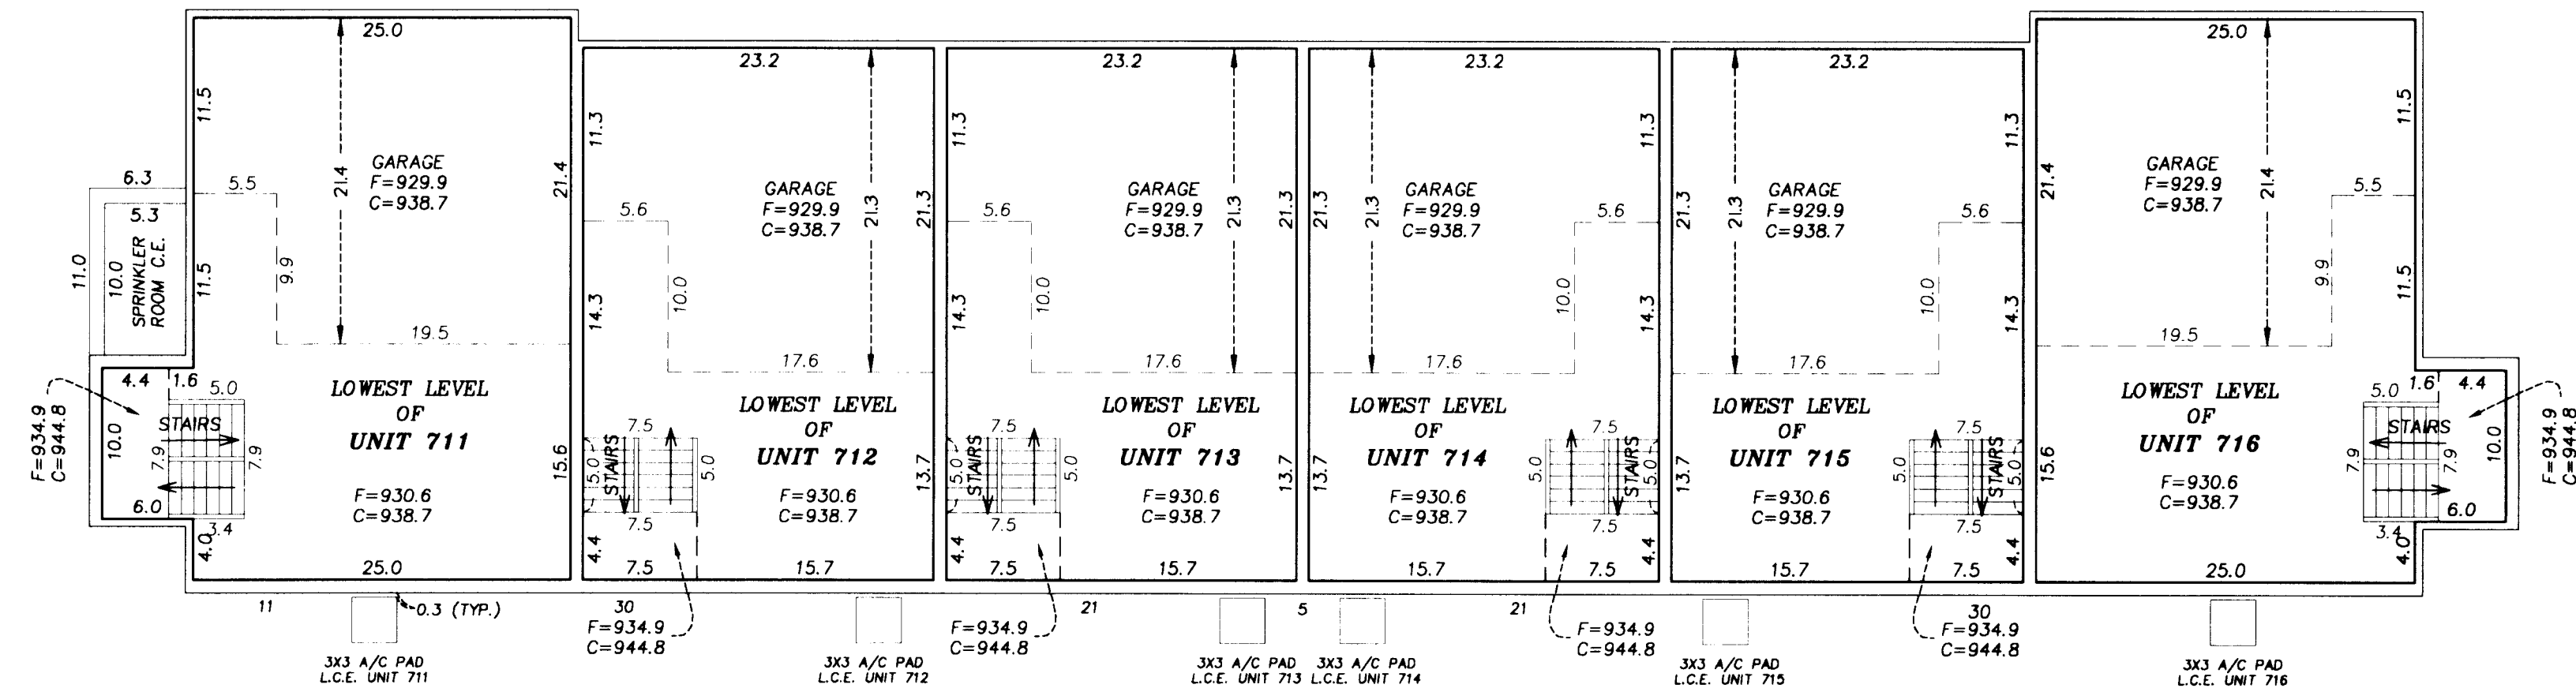

NORTH

SCALE: 1 INCH = 10 FEET

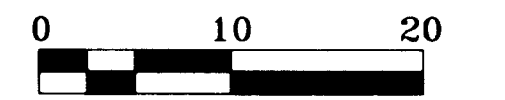


SCALE IN FEET

- C.E. - DENOTES COMMON ELEMENT
- L.C.E. - DENOTES LIMITED COMMON ELEMENT
- C - DENOTES CEILING ELEVATION
- F - DENOTES FLOOR ELEVATION
- ALL A/C PADS AND DECKS MUST BE BUILT

INTERIOR DIMENSIONS SHOWN ARE MEASURED TO THE UNFINISHED SURFACE OF THE WALLS, FLOORS AND CEILINGS.

ELEVATIONS ARE REFERENCED TO A BENCH MARK AS NOTED ON SHEET 2 OF 3 SHEETS AND ARE SHOWN IN FEET AND TENTHS OF A FOOT.

MID LEVEL -

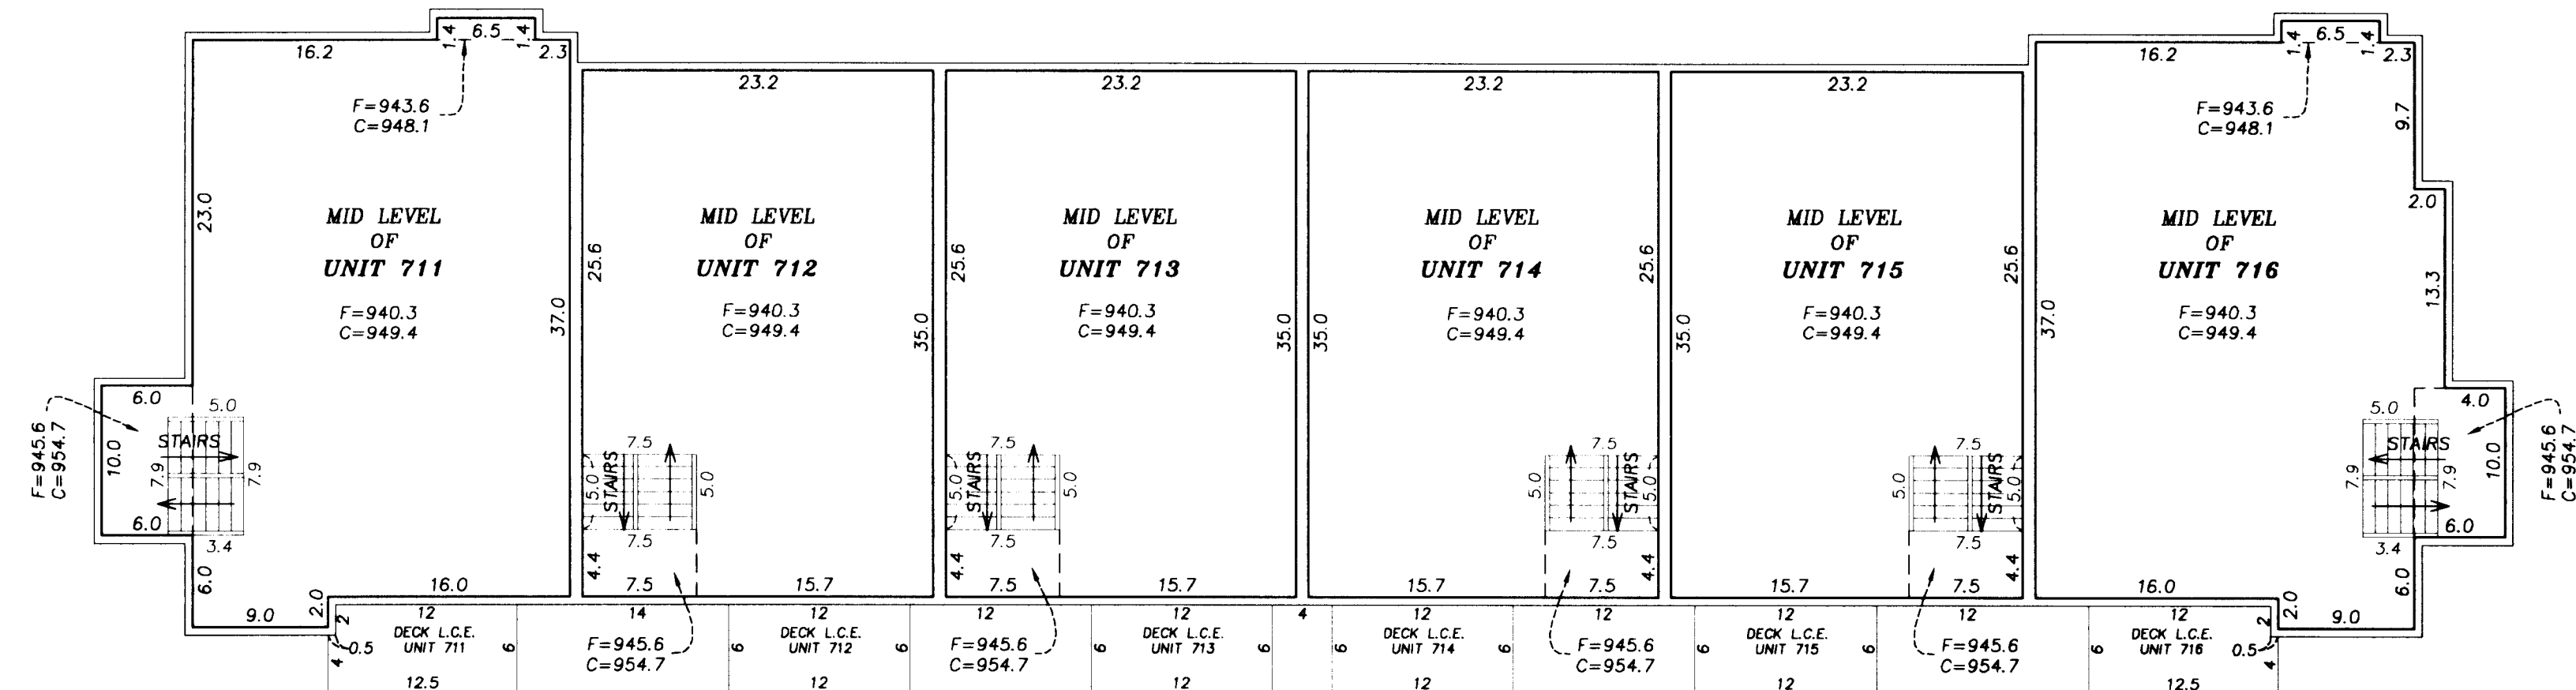

UPPER LEVEL -

